


NO.	DESCRIPTION	DATE	BY
1	AS BUILT	12/13/07	AS
2	REVISION	04/13/07	AS
3	REVISED AS BUILT	04/13/07	AS
4	REVISED AS BUILT	04/13/07	AS

ALTA/CSM LAND TITLE SURVEY
CASCADE TOWNSHIP, KENT COUNTY, MICHIGAN
EDMARK
SECTION 7, TOWN 6 NORTH, RANGE 10 WEST

NO.	DESCRIPTION	DATE	BY
1	AS BUILT	12/13/07	AS
2	REVISION	04/13/07	AS
3	REVISED AS BUILT	04/13/07	AS
4	REVISED AS BUILT	04/13/07	AS

DATE: 04/13/07	SCALE: AS SHOWN
PROJECT: EDMARK	SHEET: 11

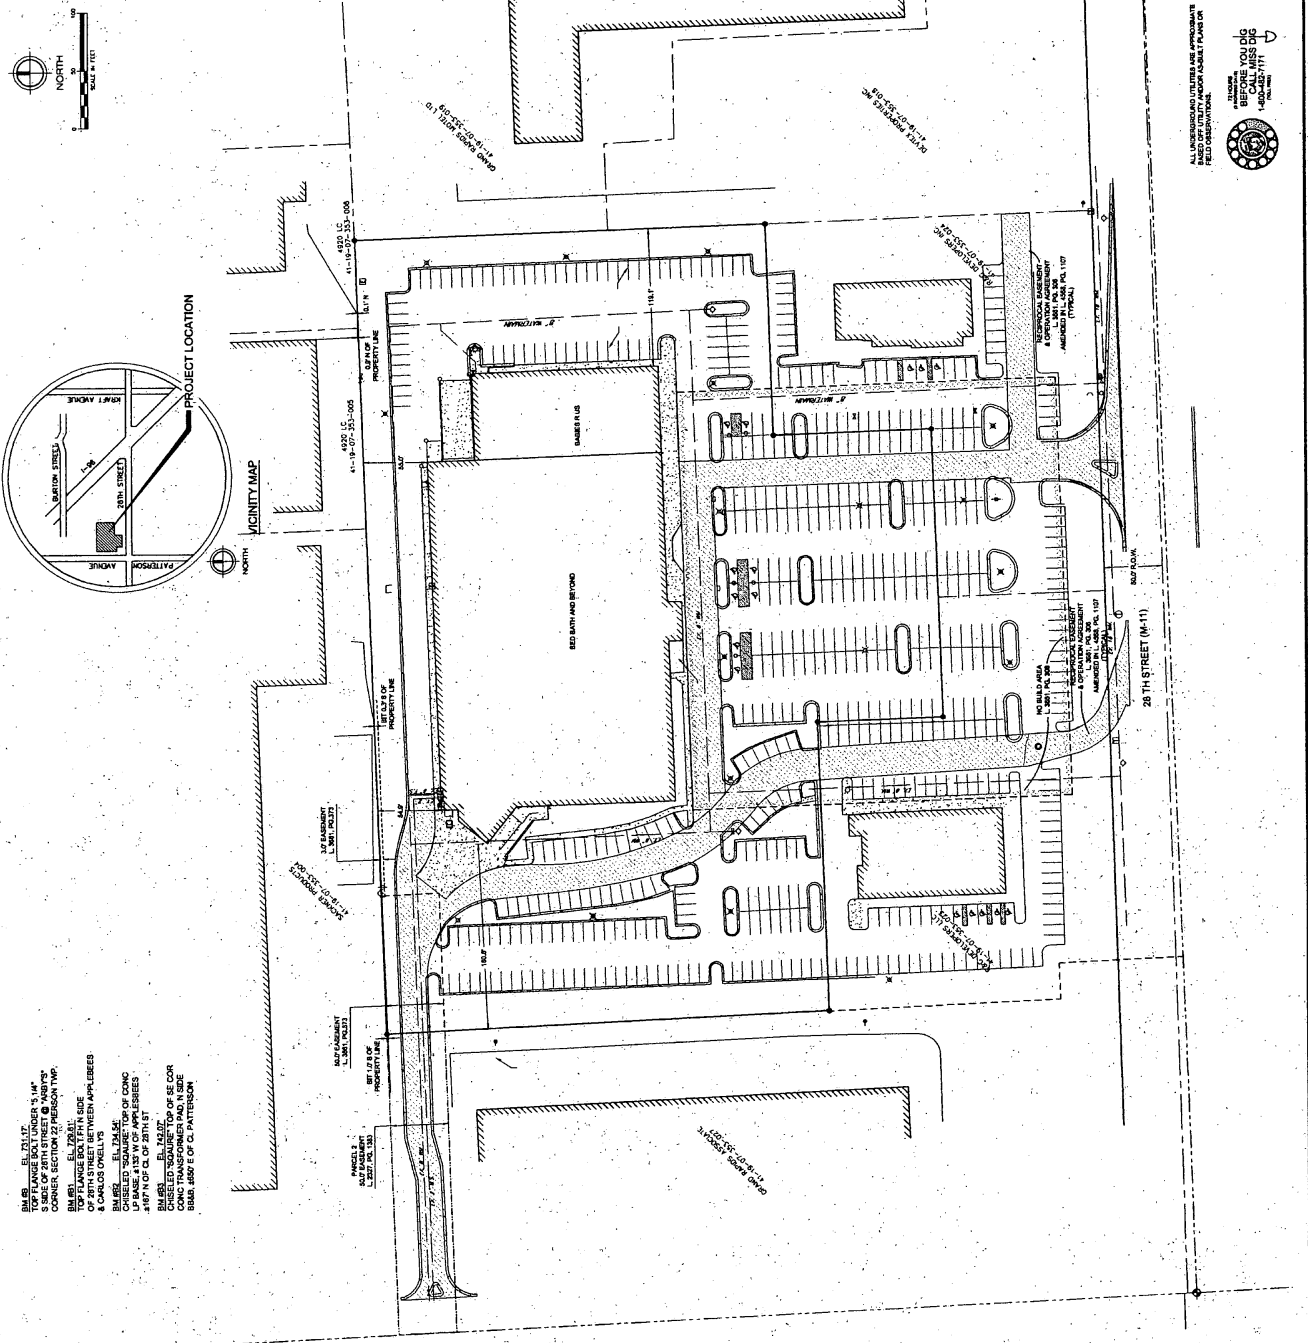

PROJECT LOCATION
VICINITY MAP

NOTES:
1. THIS SURVEY IS BASED UPON THE RECORDS OF THE PUBLIC RECORDS OF THE REGISTERED INSTRUMENTS OF THE PUBLIC RECORDS OF KENT COUNTY, MICHIGAN, AS SHOWN ON THE RECORDS OF THE REGISTERED INSTRUMENTS OF THE PUBLIC RECORDS OF KENT COUNTY, MICHIGAN.
2. THE SURVEY IS BASED UPON THE RECORDS OF THE PUBLIC RECORDS OF THE REGISTERED INSTRUMENTS OF THE PUBLIC RECORDS OF KENT COUNTY, MICHIGAN.
3. THE SURVEY IS BASED UPON THE RECORDS OF THE PUBLIC RECORDS OF THE REGISTERED INSTRUMENTS OF THE PUBLIC RECORDS OF KENT COUNTY, MICHIGAN.
4. THE SURVEY IS BASED UPON THE RECORDS OF THE PUBLIC RECORDS OF THE REGISTERED INSTRUMENTS OF THE PUBLIC RECORDS OF KENT COUNTY, MICHIGAN.
5. THE SURVEY IS BASED UPON THE RECORDS OF THE PUBLIC RECORDS OF THE REGISTERED INSTRUMENTS OF THE PUBLIC RECORDS OF KENT COUNTY, MICHIGAN.

ALTA CERTIFICATION
TOEDMARK FIRST AMERICAN TITLE INSURANCE COMPANY
THIS IS TO CERTIFY THAT THIS MAP OR PLAN AND THE SURVEY ON WHICH IT IS BASED WERE MADE IN ACCORDANCE WITH THE ALTA CERTIFICATION AND THE SURVEY WAS MADE BY A LICENSED SURVEYOR.
I, **JAMES C. WEAVER**, REGISTERED PROFESSIONAL SURVEYOR, STATE OF MICHIGAN, LICENSE NO. 33142, DO HEREBY CERTIFY THAT I HAVE PERSONALLY CONDUCTED THIS SURVEY AND THAT I AM A MEMBER IN GOOD STANDING WITH THE SURVEYORS ASSOCIATION OF MICHIGAN.
DATE: APRIL 13, 2007
BY: JAMES C. WEAVER, REGISTERED PROFESSIONAL SURVEYOR, STATE OF MICHIGAN, LICENSE NO. 33142

LEGEND
SYMBOL DESCRIPTION SYMBOL DESCRIPTION
● CABLE BOX
□ TELEPHONE RISER
▲ BENCHMARK
○ TELEPHONE MANHOLE
◇ SECTION CORNER
⊖ ELECTRICAL RISER
⊕ PROPERTY LINE
⊖ ELECTRICAL MANHOLE
○ POWER POLE
○ 10000 SQUARE FOOT FLOOR AREA
○ 3230 SQUARE FOOT FLOOR AREA
○ 283 BATH AND BLDG
○ 10000 SQUARE FOOT FLOOR AREA
○ 3230 SQUARE FOOT FLOOR AREA
○ 283 BATH AND BLDG
○ 10000 SQUARE FOOT FLOOR AREA
○ 3230 SQUARE FOOT FLOOR AREA
○ 283 BATH AND BLDG
○ 10000 SQUARE FOOT FLOOR AREA
○ 3230 SQUARE FOOT FLOOR AREA
○ 283 BATH AND BLDG

ALTA CERTIFICATION
TOEDMARK FIRST AMERICAN TITLE INSURANCE COMPANY
THIS IS TO CERTIFY THAT THIS MAP OR PLAN AND THE SURVEY ON WHICH IT IS BASED WERE MADE IN ACCORDANCE WITH THE ALTA CERTIFICATION AND THE SURVEY WAS MADE BY A LICENSED SURVEYOR.
I, **JAMES C. WEAVER**, REGISTERED PROFESSIONAL SURVEYOR, STATE OF MICHIGAN, LICENSE NO. 33142, DO HEREBY CERTIFY THAT I HAVE PERSONALLY CONDUCTED THIS SURVEY AND THAT I AM A MEMBER IN GOOD STANDING WITH THE SURVEYORS ASSOCIATION OF MICHIGAN.
DATE: APRIL 13, 2007
BY: JAMES C. WEAVER, REGISTERED PROFESSIONAL SURVEYOR, STATE OF MICHIGAN, LICENSE NO. 33142



ALL UNDERGROUND UTILITIES ARE APPROXIMATELY LOCATED FROM NEAREST PLANT OR FIELD OBSERVATION.

BEFORE YOU DIG CALL 811
MICHIGAN 811